



BRIDGE ACROSS TRUCKEE RIVER
NEAR MILE 107.5
GENERAL PLAN

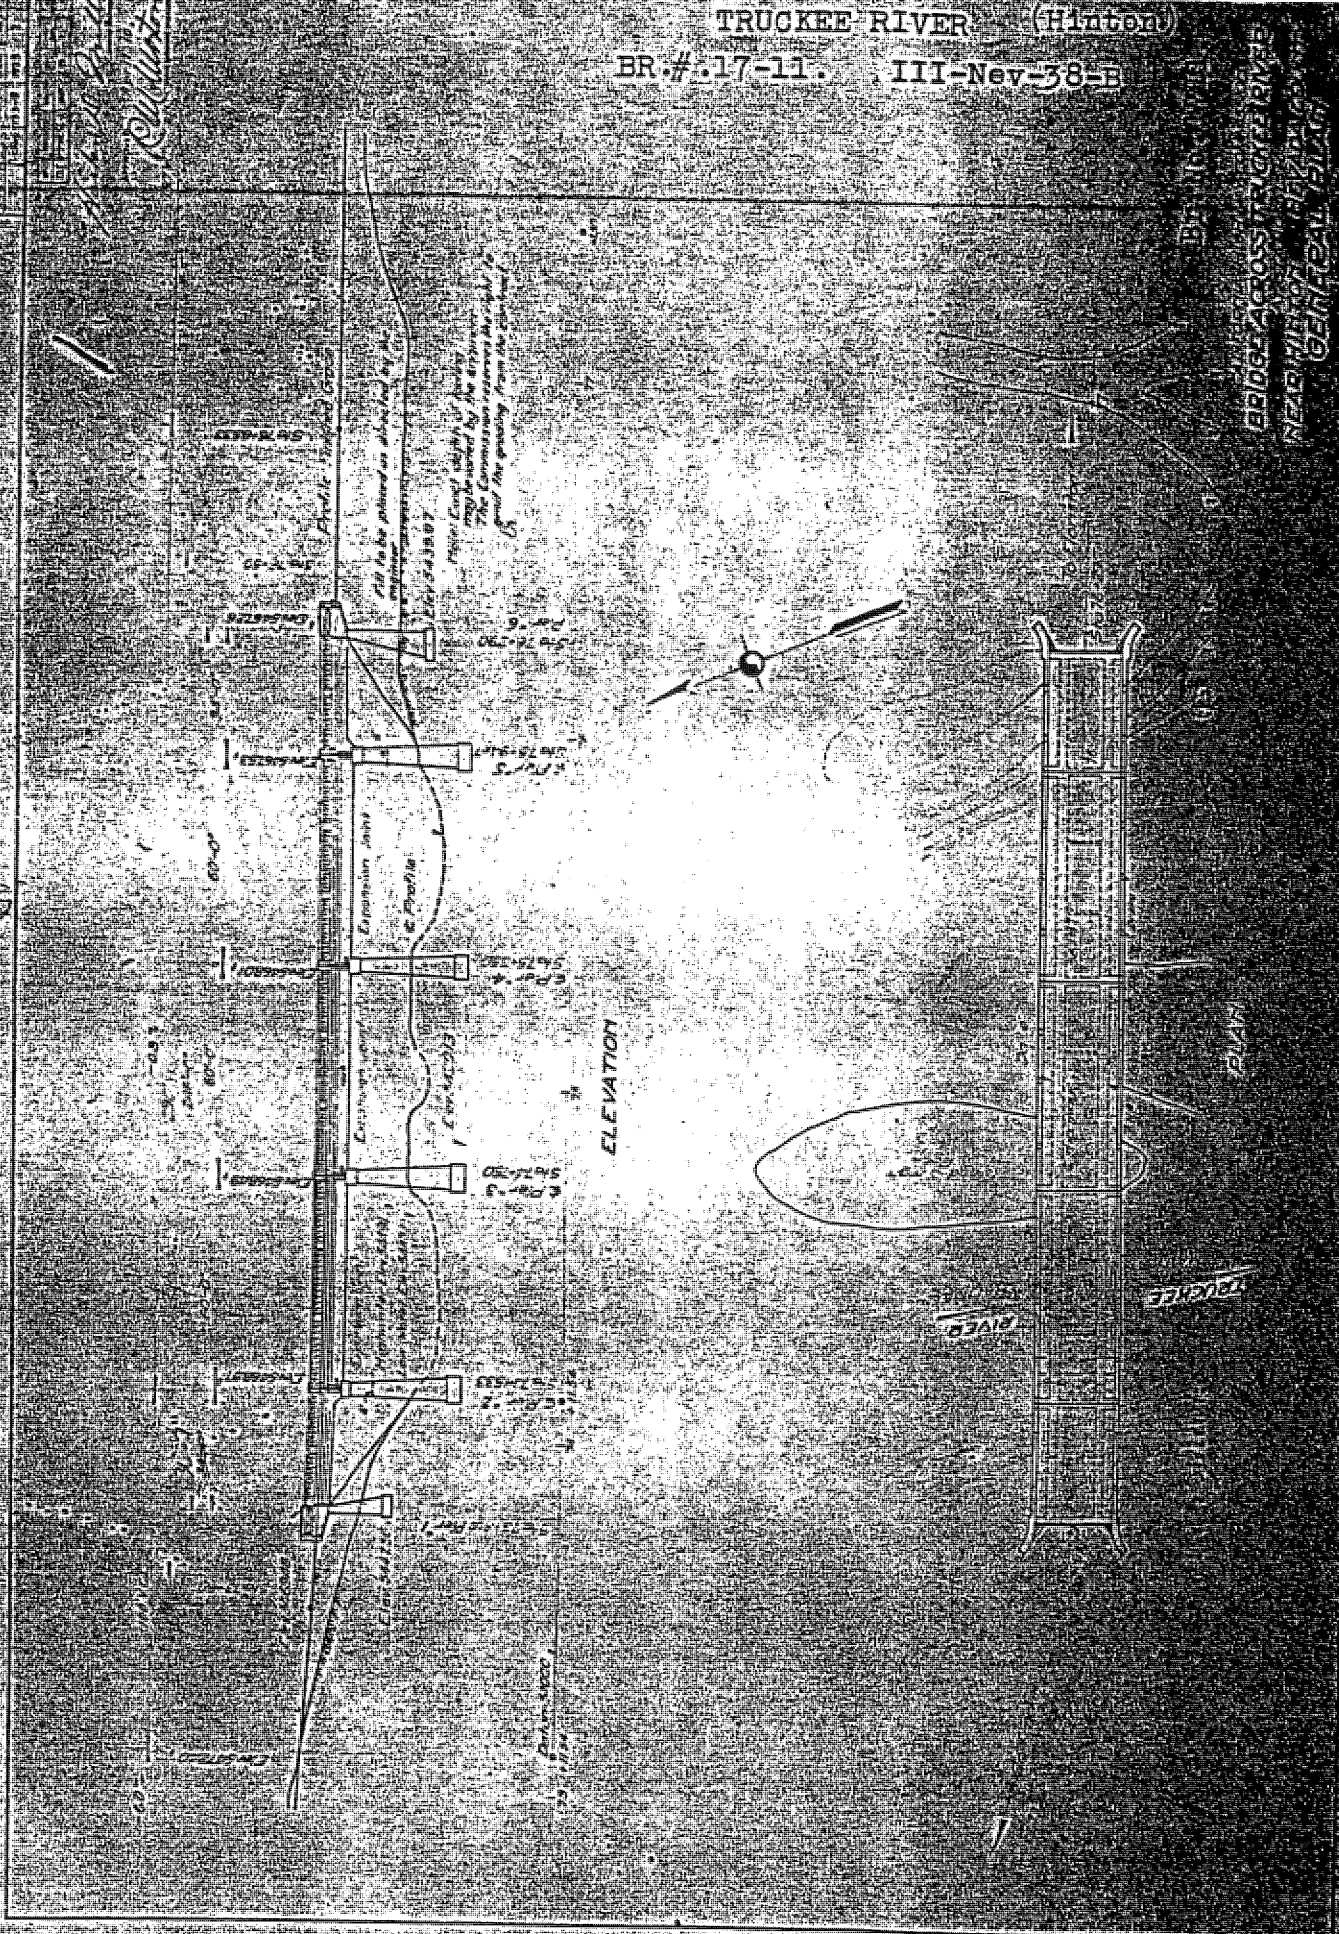

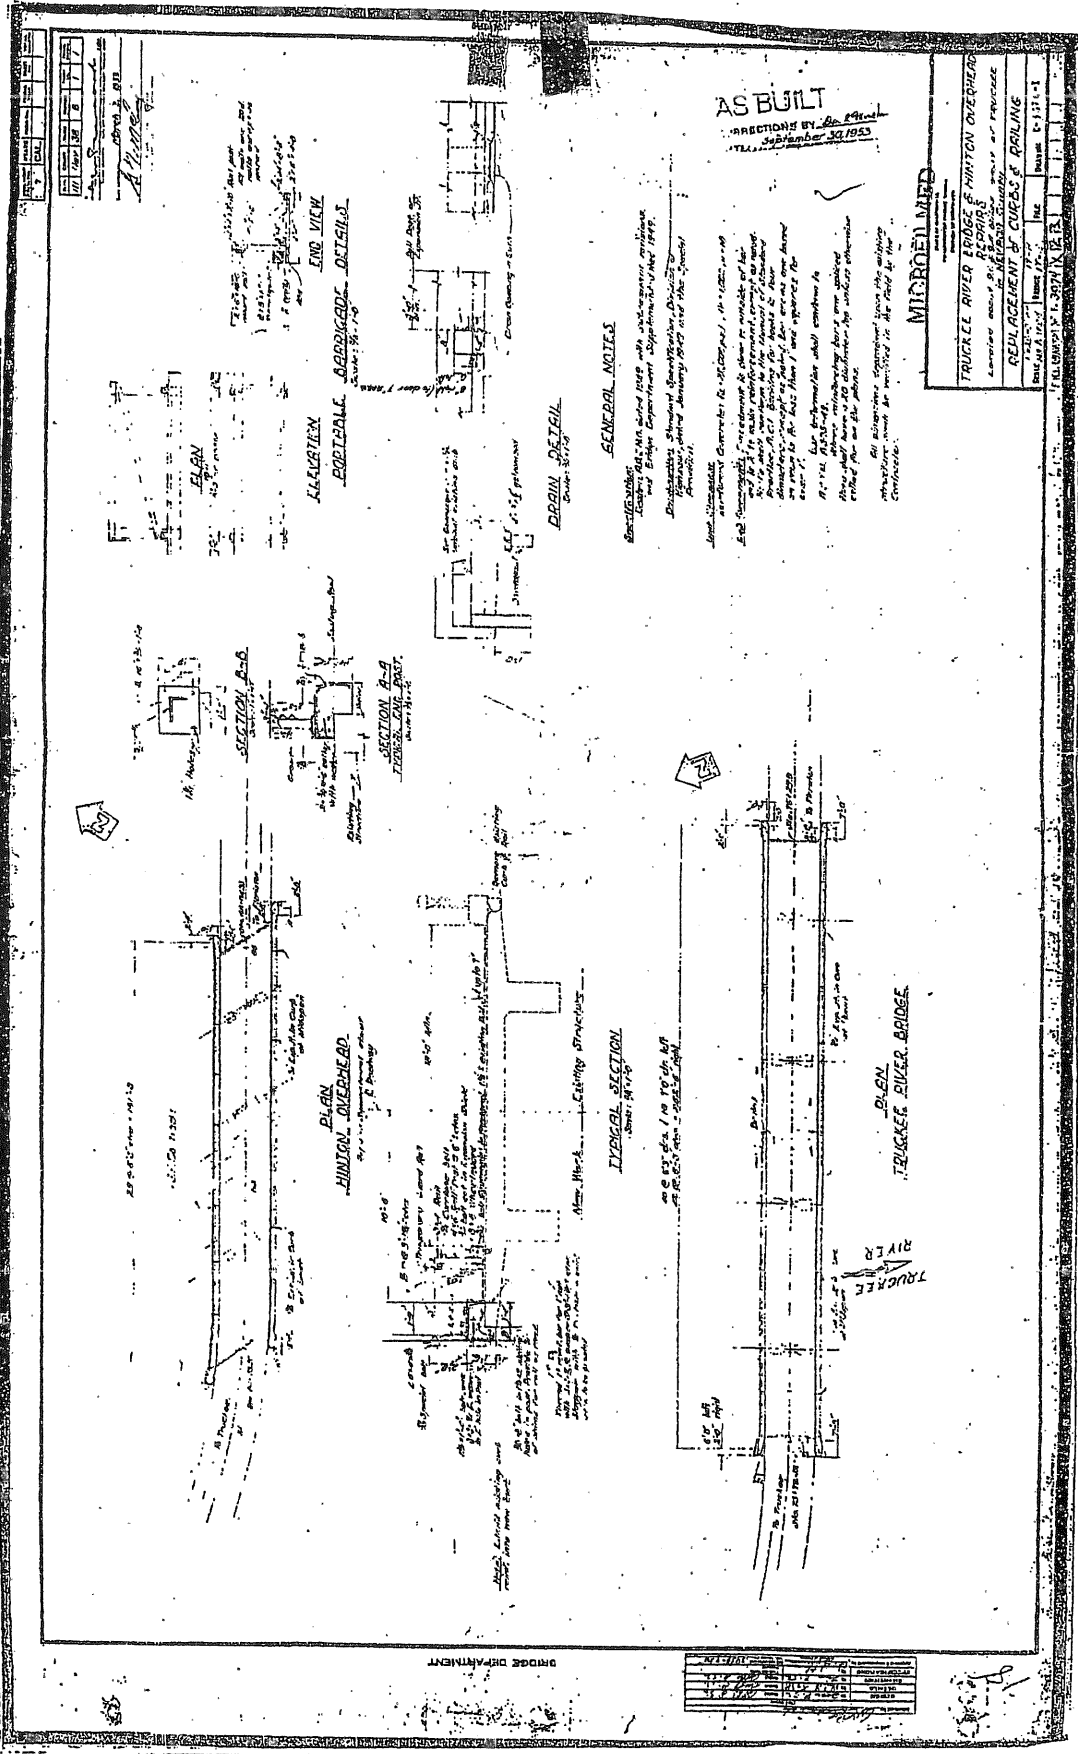

AS BUILT
 REVISIONS BY: [Signature]
 DATE: September 30, 1953

GENERAL NOTES

1. Bridge deck and floor slab with unreinforced concrete and bridge deck pavement shall conform to the 1949 Specifications for Highway Construction, Division 200, Section 201.01, and Division 200, Section 201.02.

2. Bridge deck and floor slab shall be cast in place concrete.

3. Bridge deck and floor slab shall be finished with a smooth surface.

4. Bridge deck and floor slab shall be finished with a smooth surface.

5. Bridge deck and floor slab shall be finished with a smooth surface.

6. Bridge deck and floor slab shall be finished with a smooth surface.

7. Bridge deck and floor slab shall be finished with a smooth surface.

8. Bridge deck and floor slab shall be finished with a smooth surface.

9. Bridge deck and floor slab shall be finished with a smooth surface.

10. Bridge deck and floor slab shall be finished with a smooth surface.

MICROFILMED

TRUCKEE RIVER BRIDGE AT HUNTON OVERHEAD
 REPAIRS
 REPLACEMENT OF CURBS & RAILING

DATE: 10/1/53
 DRAWN BY: [Signature]
 CHECKED BY: [Signature]
 SCALE: AS SHOWN

BRIDGE DEPARTMENT

NO.	DESCRIPTION	DATE
1	AS BUILT	SEP 30 1953
2		
3		
4		
5		